

**CITY OF NORTHAMPTON  
MASSACHUSETTS**

*In the Year Two Thousand and Twenty-Six*

Upon the Recommendation of Transportation and Parking Commission

**26.039  
AN ORDINANCE**

**RELATIVE TO BUS STOP ON ELM STREET**

An Ordinance of the City of Northampton, Massachusetts. Be it ordained by the City Council of the City of Northampton, in City Council assembled, as follows:

SECTION 1

*That the § 312-114 of the Code of Ordinances be amended as follows:*

§ 312-114 Schedule XIII: Bus Stops.

[Last amended 11-20-2025 by Ord. No. 25.320]



Bus stops are established at the following locations:

Location	Side	From	To
Northampton High School & N. Elm St. – PVTA #235	NW	A point <del>207</del> <b>333</b> ft. southerly from Elm St.	A point <del>299</del> <b>408</b> ft. southerly from Elm St.

# Parking Schedule on Elm and North Elm Streets

Existing Parking Ordinance(s)

Proposed Parking Ordinance(s)

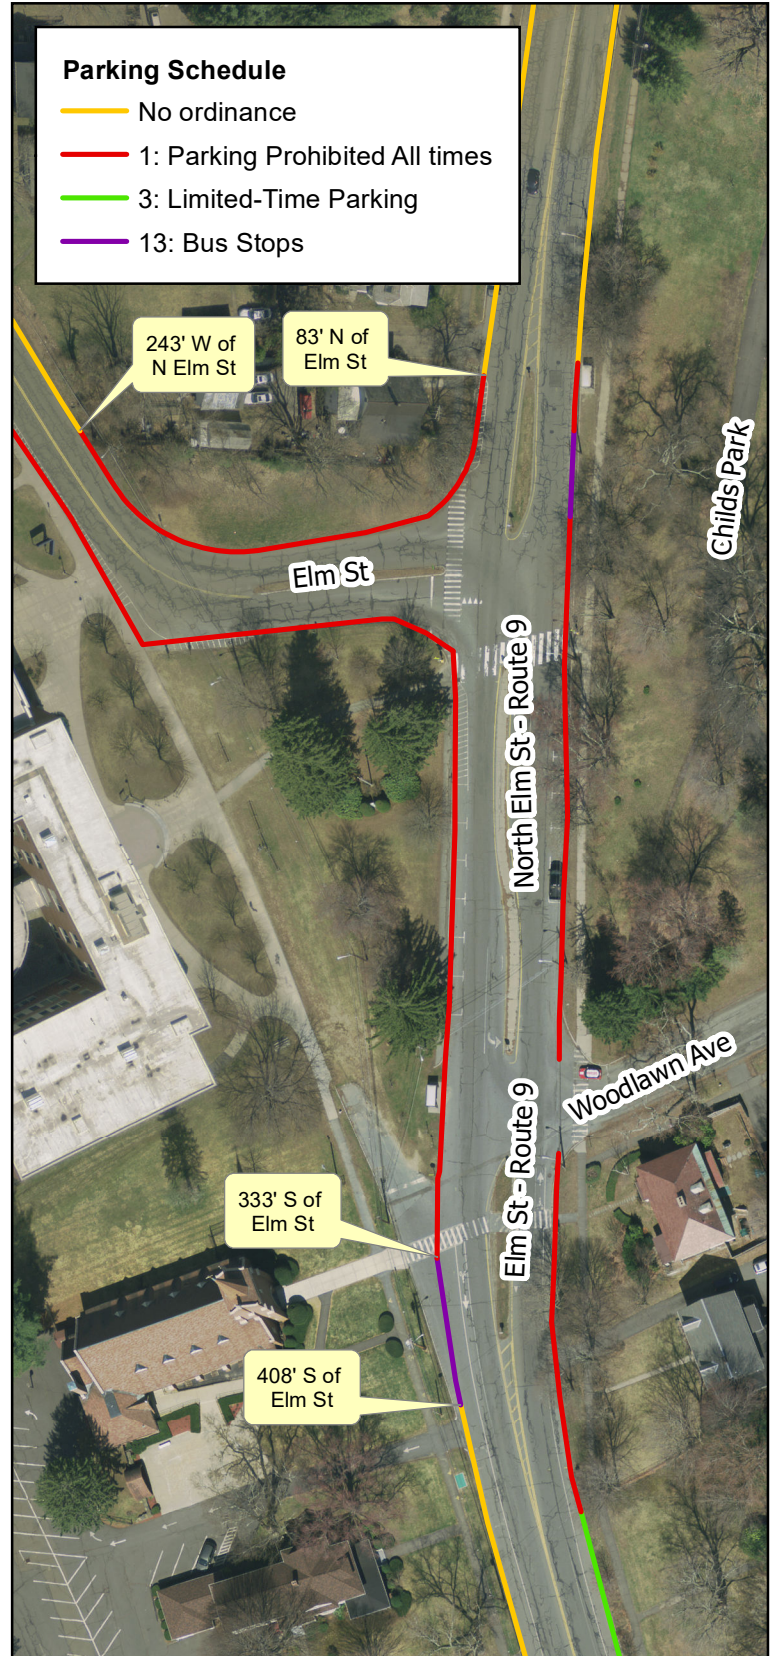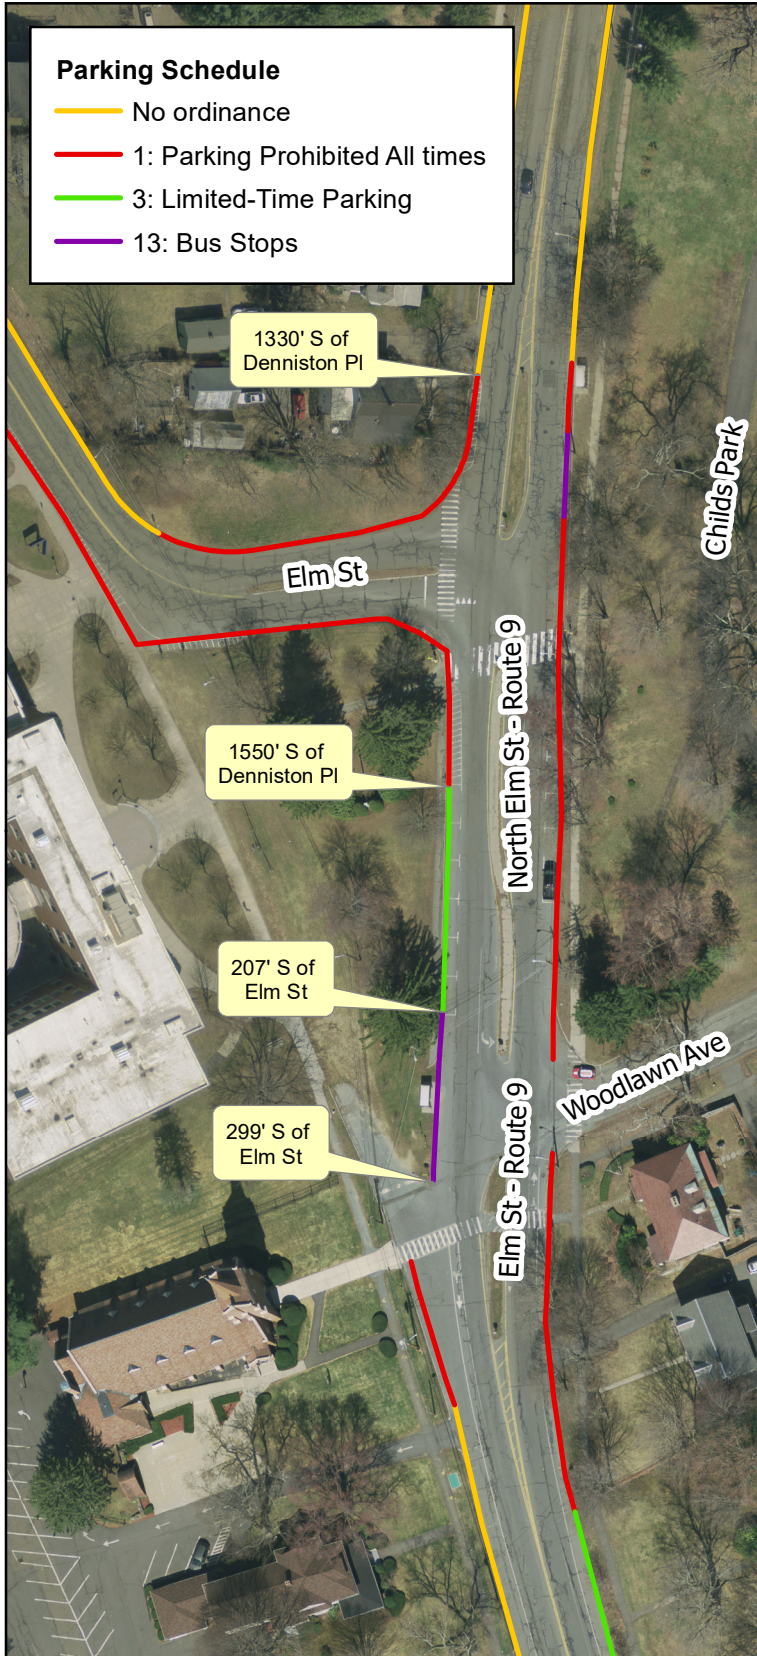

**City of Northampton**

Prepared by:  
Engineering Division  
Department of Public Works  
City of Northampton

March 12, 2026



1" = 100'

Disclaimer: The information on this map was derived from digital databases on the City of Northampton's GIS. Care was taken in the creation of this map. The City of Northampton cannot accept any responsibility for errors, omissions, or positional accuracy. Notification of any errors will be appreciated.